

Planned Outage and Interruption Request

Work Owner _____ Organization _____ Phone _____

Onsite Contact _____ Phone _____

Project # _____ Customer Request _____ WO Number _____

Select Interruption Type:

Building System Outage or Space Closure (Only if part of a building is out, Check all that apply)		Building Access Control		Elevator		Laboratory Utility		Sanitary Sewer
		Electric Power		Heating Ventilation & A/C (HVAC)		Natural Gas		Domestic Water
		Building Space/Entrances/ Occupant Flow		Telephone/IT		Fumehood		Cooler/Freezer
		Emergency Power (Life Safety Approval required)		Other (Explain below)				
Utility Outage (If entire building is out)		Electric Power		Natural Gas		Sewer from Building		Domestic Water
		Hot Water (Central Plant)		Chilled Water (Central Plant)		Steam (Central Plant)		Other (Explain Below)
Outside Closures		Roadway		Sidewalk		Bike Lane		Waste Receptacle
		Parking Spaces		ADA Facilities		Traffic Signal		Other (Explain below)
Life Safety System Outage (Required any time system or components are taken out of service)		Fire Alarm		Fire Suppression System and/or Fire Pump		Special Hazards Range Hood		Fire Hydrant
		Fire watch required? Yes or No (Determined by Risk Management & Safety and University Engineer)				Note:		
Life Safety Notifications		Annual Fire Alarm Test and Inspection		Fire Suppression System Testing		Fire Alarm System Testing		Fire Alarm System Download
Notifications		Unplanned Outage		Preventative Maintenance		Risk Mgt. & Safety Inspection		Other (Explain below)

Description of Work Activity

Building(s) or Location(s) Affected

Specific Space Affected (Room Numbers)

How are the building clients or University stakeholders affected? What will they notice?

Schedule:

Start Date: _____ **Start Time:** _____ **End Date:** _____ **End Time:** _____

Planned Outage and Interruption Request

Planning Reviews (Per Review Matrix):

Organization	Review Required?	Reviewer	Review Date
Maintenance Zone Manager or Supervisor			
Utility Supervisor			
Others as Needed			

Client Approvals (Per Approval Matrix):

Organizations Affected by Work, Interruption, or Outage			
Client	Building(s)	Key Contact	Approval Date

Facilities Management Approvals (Per the Approval Matrix)

Facilities Management								
Maintenance			Utility and Energy			Design & Construction		
Approval Required?	Approved By:	Date	Approval Required?	Approved By:	Date	Approval Required?	Approved By:	Date
	Eric Moore							
Campus Services/Landscape								
Approval Required?	Approved By:	Date						
For Life Safety Systems								
University Engineer			Risk Management and Safety					
Approval Required?	Approved By:	Date	Approval Required?	Approved By:	Date			
	Bob Hix			Elizabeth De Kruif				
Work Management								
Received By:		Date Received	Time Received		Date Notice Issued		Time Issued	

Work Owner Signature: Justin Gilliam Date _____

Planned Outage and Interruption Request


Form Purpose

This form is required any time a planned outage, space closure or outside facility closure is needed. The intent is to document approval and provide the information necessary for concise communication of these events to the campus and others with need to know. It is also used to provide information necessary to communicate unplanned outages, Preventative Maintenance activities, and other events to the campus community.

The Work Owner is responsible for planning and scheduling the outage or closure, obtaining the necessary approvals, and submitting the completed form to Work Management. Work Management will then issue the communication to the appropriate campus stakeholders.

Information and Instructions

1. **Work Owner** – Individual responsible for conduct of the work requiring the interruption or outage. Include Auburn University Organization and cell phone number.
2. **Onsite Contact** – Individual directly responsible for the conduct of the work and typical will be on site during implementation. Include cell phone number.
3. **Project Number** – Auburn University Facilities project number if applicable
4. **Customer Request** – AiM Request number if applicable.
5. **WO Number** – AiM work order number if applicable.
6. **Interruption Type** – Select the system, component or space type that will be interrupted and out of service. Select all that apply, however if a utility outage is selected and the entire building will be interrupted do not select individual building systems. As example, do not select HVAC in a building if electric power will be off to the entire building.
7. **Life Safety System Outage** – Required if a life safety system or system component is taken out of service, or if any other system (domestic water, electric power) is taken out of service and prevents life safety system from functioning. Outages on life safety system require approval of Risk Management and Safety and University Engineer. They will determine if a fire watch will be required.
8. **Life Safety Notifications** - Used to communicate to building occupants and others when listed activities are taking place. No review or approval required.
9. **Notifications** - Used to communicate unplanned outages to campus. Can also be used to communicate Preventative Maintenance activities, Risk Management and Safety Inspections and Other activities as needed.
10. **Description of Work Activity** – Describe specifically what work will be performed during the outage.
11. **Building(s) or Location(s) Affected** – List all buildings affected using official university name. If outside space describe the location of the activity including buildings that will be directly impacted if necessary.
12. **Specific Space Affected** – Provide floor, room numbers, or area of the building that will be affected.
13. **How are the building clients or University stakeholders affected? What will they notice?** – Provide sentence on the specific impact of the outage and describe what University stakeholders will notice.
14. **Schedule** – Provide start and estimated end dates and times
15. **Planning Reviews** – Discussions conducted with designated individuals during the planning and scheduling phase of the outage or interruption. The review matrix defines the minimum reviews required, additional reviews may be required depending on the nature of the work. No signature or hard approval documentation is required for reviews.
16. **Client Approvals** – Obtain approval of Key Contact of all organizations with assigned space in affected buildings or in buildings near the work. Client approval can be documented with e mail or signature on the form. On short notice outages, verbal client approval is acceptable.
17. **Facilities Management Approvals** – Obtain necessary approval based on the type of outage and the required approvals from the approval matrix.
18. **Work Manager Signature** – Sign and date the form and submit to Work Management

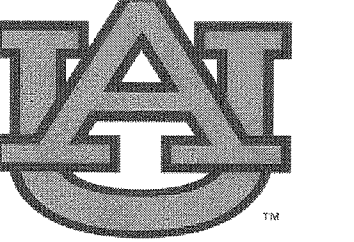

Enter address here



owner:
Auburn University
Office of President-Facilities Div.
Samford Hall
Auburn, AL 36849

architect:
360 ARCHITECTURE INC
2020 BALTIMORE, SUITE 400
KANSAS CITY, MO 64108
T: 816.472.3350
F: 816.472.2100

construction management:
Robins & Morton
400 Shades Creek Parkway
Birmingham, AL 35209
T: 205.870.1000

associate architect:
Davis Architects, Inc.
120 2nd St., South
Birmingham, AL 35233
T: 205.322.7462

structural:
Walter P. Moore & Associates
920 Main Street, 10th Floor
Kansas City, MO 64105-2008
T: 816.701.2100

associate structural:
MSA Structural Engineers
300 20th Street North, Suite 100
Birmingham, AL 35203
T: 816.701.2100


mechanical, electrical, plumbing & fire protection
Smith Seckman Reid, Inc.
2995 Sidco Drive
Nashville, TN 37204
T: 615.383.1113

civil:
LBVD, Inc.
716 South 30th Street
Birmingham, AL 35233
T: 205.251.4500

landscape architect:
Holcombe Norton & Pritchett
1914 28th Avenue South
Birmingham, AL 35209
T: 205.870.9936


acoustic/ audio-visual consultant:
WJHV, Inc.
4801 Spring Valley Road #113
Dallas, TX 75224
T: 972.534.3700

food service consultant:
FSC, Inc.
3100 South 24th Street, Suite E
Kansas City, KS 66106
T: 816.722.3473

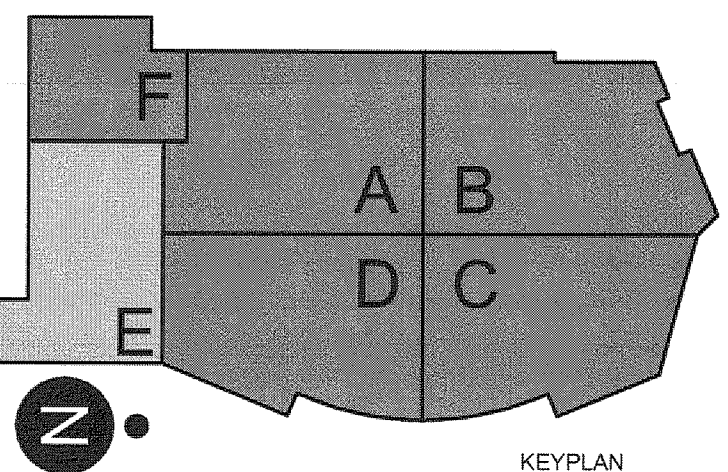

COPYRIGHT © 2008 360 ARCHITECTURE INC

seal/signature

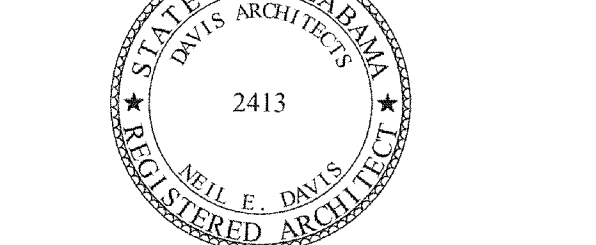


rev	date	description
	06/30/08	Construction Set
	ASI - 122	- VOID
	ASI - 122.1	- VOID
1	08/24/09	ASI - 122.2
	09/15/10	Record Set

date	Issue Date: March 3, 2008
phase	100% Construction Documents
issued for	Bidding / Permit
issued by	Davis Architects project # 070250.00

Administration Level Sector E

sheet number
A202E

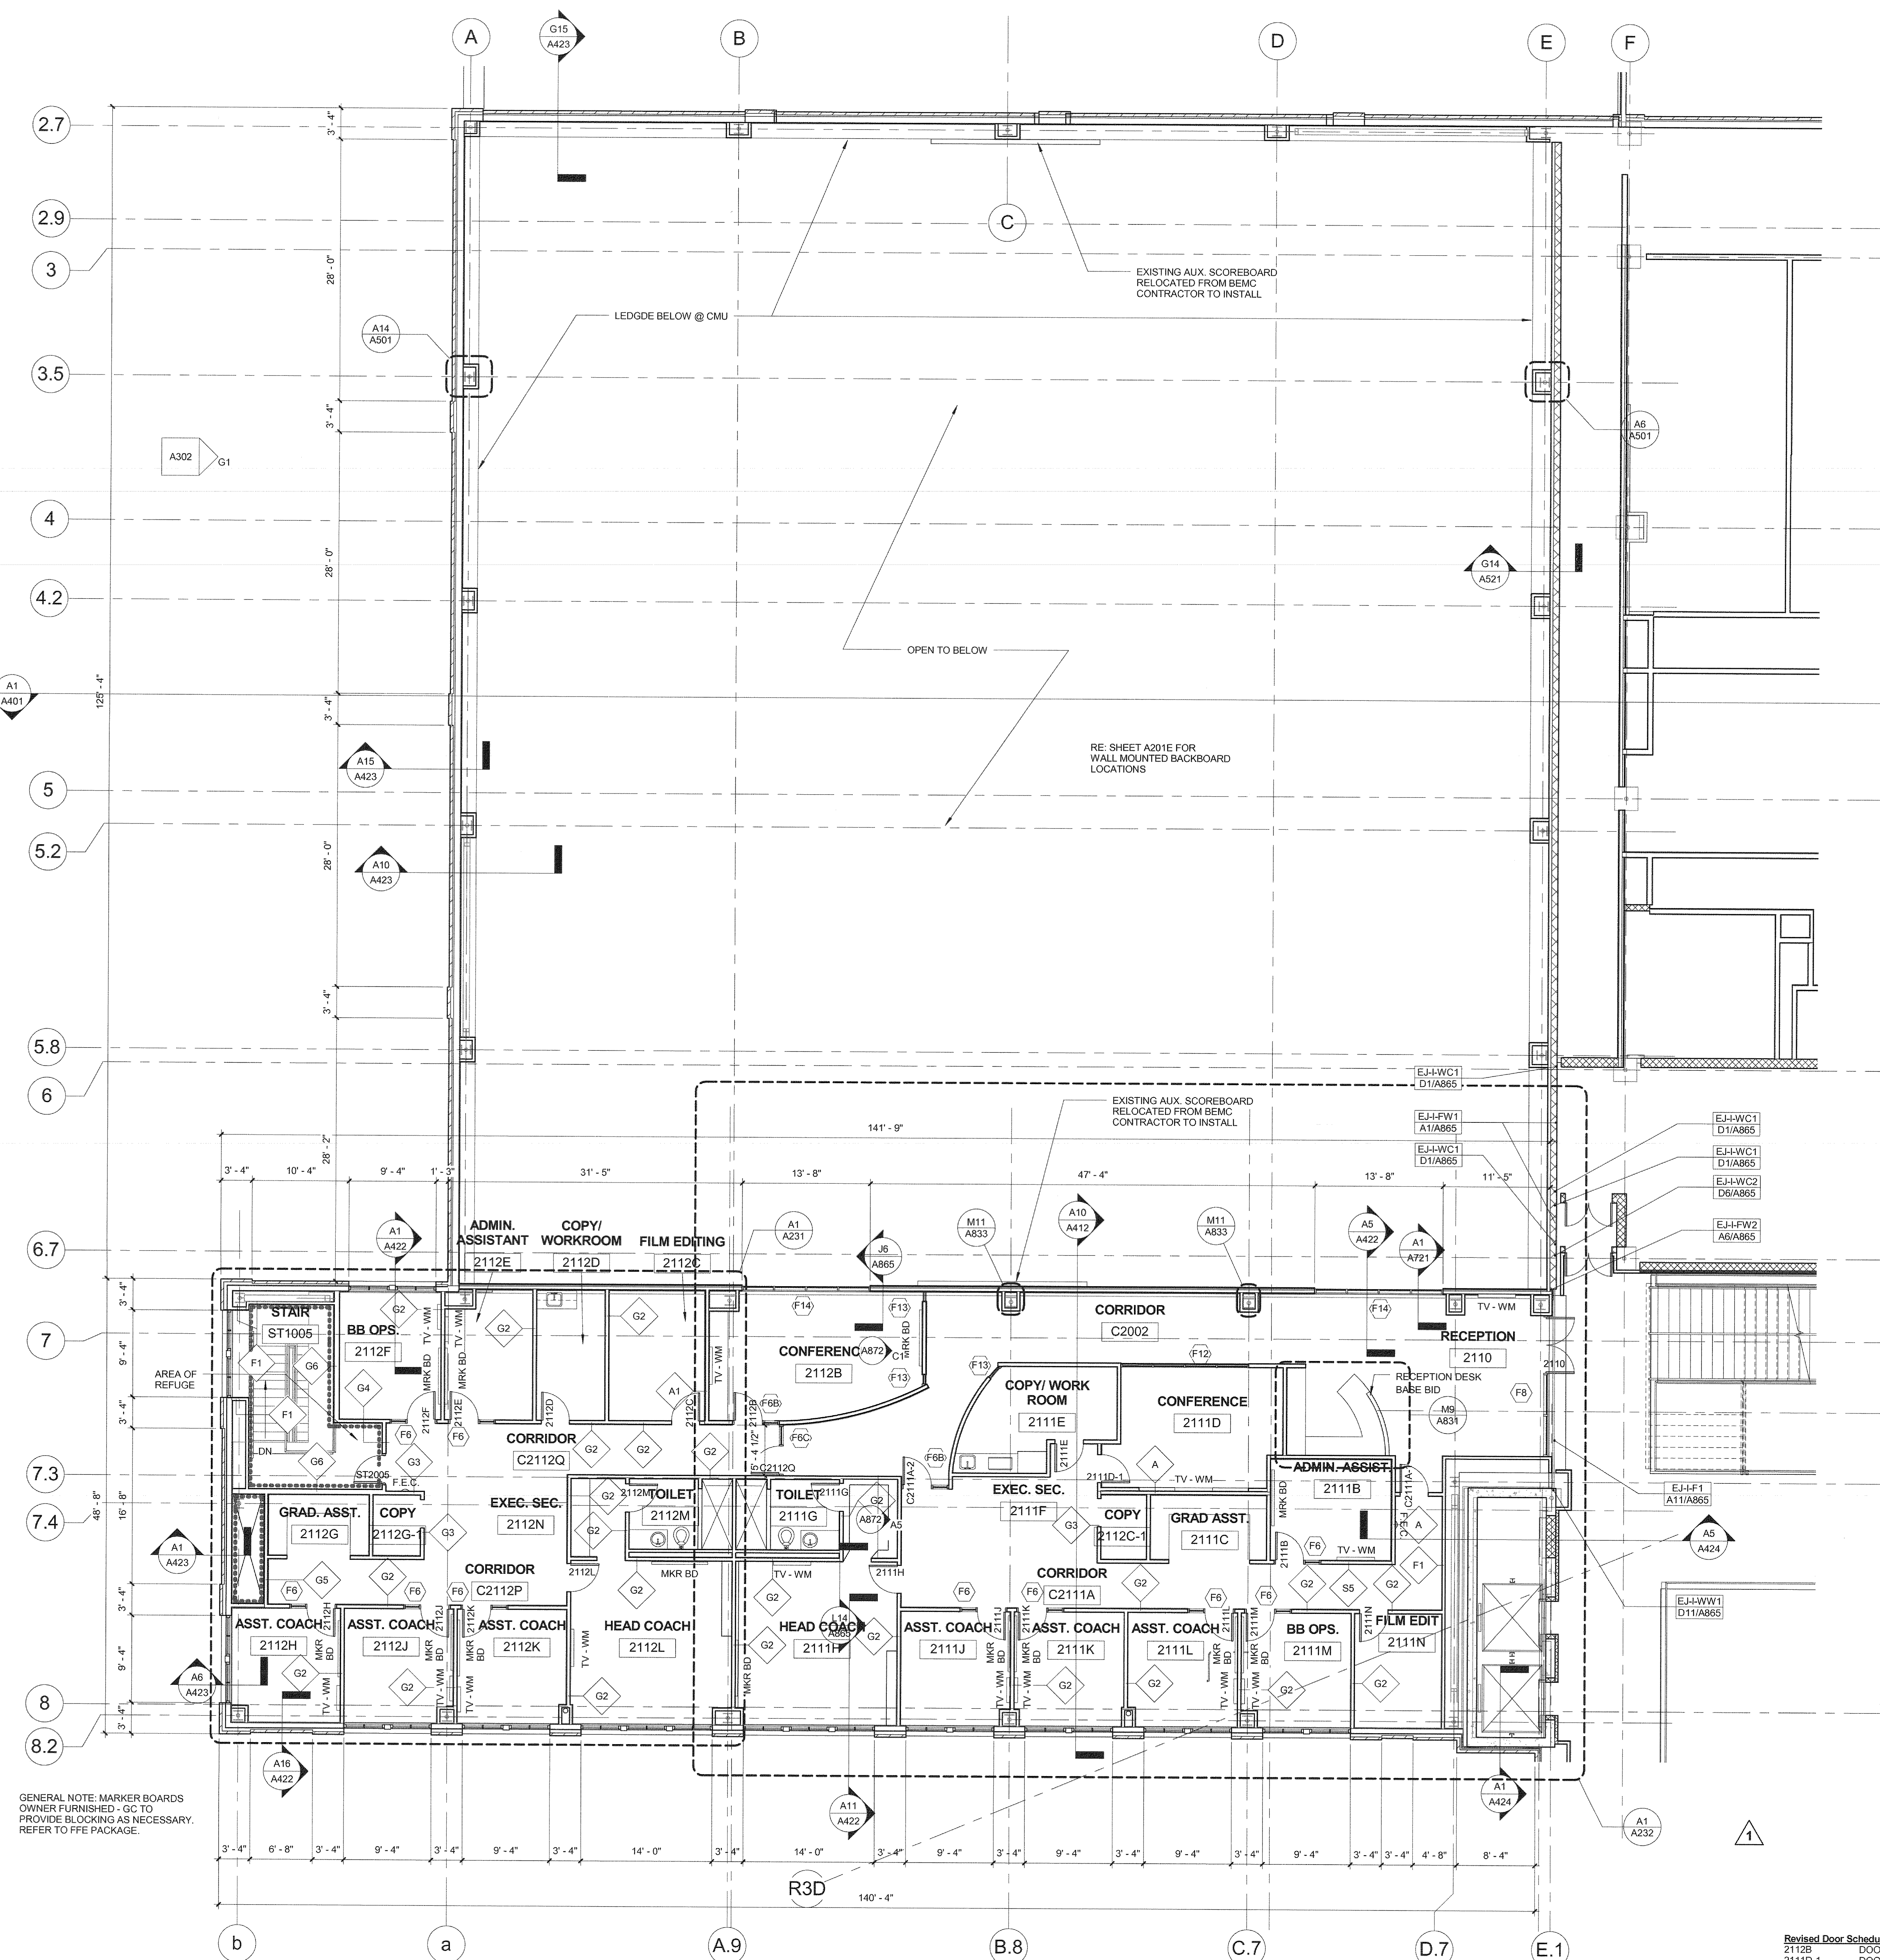

GENERAL NOTE: MARKER BOARDS
OWNER FURNISHED - GC TO
PROVIDE BLOCKING AS NECESSARY.
REFER TO PFE PACKAGE.



RATED WALL LEGEND	
-----	1 HR WALL
-----	2 HR WALL
-----	SMOKE PROTECTED

Revised Door Schedule (ASI-122):	
2112B	DOOR - 3'-0" x 7'-10" SCW, WD-2, A
2111B-1	DOOR - 3'-0" x 7'-10" SCW, WD-2, A
C2111A-2	DOOR - 3'-0" x 7'-10" SCW, WD-2, B.1
C2112D	DOOR - 3'-0" x 7'-10" SCW, WD-2, B.1
2111D-2	ELIMINATED FROM PROJECT
FRAME - WD, F88, 13, NOTE 6, 22	
FRAME - WD, F14, NOTE 6, 22	
FRAME - WD, F68, A16/A011 E16/A011, 22	
FRAME - WD, F6C (REFER TO F6/A005 - 1' - 11" SIDELITE (ASI-122)), A16/A011 E16/A011, 22	

A1 Administration Level- Sector E

A1/A301 1/8" = 1'-0"

9/8/2010 10:51:05 AM

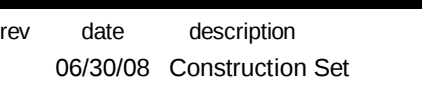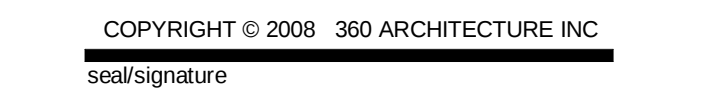


Issue Date:	March 3, 2008
100% Construction Documents	
Bidding / Permit	
360 Architecture	070250.00

Administration Level Sector D

sheet number

A202D

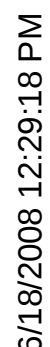

date	Issue Date: March 3, 2008	
phase	100% Construction Documents	
issued for	Bidding / Permit	
issued by	project #	SSR 070250.00

sheet number

FP202E



Year	Percentage of Respondents (%)
1997	65
1998	75
1999	70
2000	65
2001	70
2002	75
2003	70
2004	65

_____
secd/signature

FIRE PROTECTION PLAN
ADMINISTRATION LEVEL
SECTOR D

sheet number

FP202D



scale: 1/8"=1'-0"

FIRE WATCH PATROL LOG SHEET

Address: _____

Fire Watch Duties Conducted By: _____
(print name & position)

Fire Watch Commenced: Date: _____ Time: _____

ROUNDS	DATE (m/d/y)	START TIME (circle a.m./p.m.)	FINISH TIME (circle a.m./p.m.)	AREAS PATROLLED & COMMENTS	INITIALS
1.	/ /	a.m. p.m.	a.m. p.m.		
2.	/ /	a.m. p.m.	a.m. p.m.		
3.	/ /	a.m. p.m.	a.m. p.m.		
RE: Neville Arena Sprinkler Outage Request

From Eric Moore <jem0028@auburn.edu>

Date Mon 2025-05-19 9:05 AM

To Justin Gilliam <jmg0047@auburn.edu>; Bruce Arnold <gba0004@auburn.edu>; Scott McClure <mccluws@auburn.edu>; Fred Buchanan <buchaf1@auburn.edu>; Travis Tally <tallytp@auburn.edu>; Bob Hix <hixjame@auburn.edu>; Nolan Yon <yonbenj@auburn.edu>; Jessica Covington <jlc0105@auburn.edu>; Elizabeth De Kruif <erd0023@auburn.edu>

Cc Anna Thompson <gueriak@auburn.edu>

I approve

From: Justin Gilliam <jmg0047@auburn.edu>

Sent: Monday, May 19, 2025 8:56 AM

To: Eric Moore <jem0028@auburn.edu>; Bruce Arnold <gba0004@auburn.edu>; Scott McClure <mccluws@auburn.edu>; Fred Buchanan <buchaf1@auburn.edu>; Travis Tally <tallytp@auburn.edu>; Bob Hix <hixjame@auburn.edu>; Nolan Yon <yonbenj@auburn.edu>; Jessica Covington <jlc0105@auburn.edu>; Elizabeth De Kruif <erd0023@auburn.edu>

Cc: Anna Thompson <gueriak@auburn.edu>

Subject: Neville Arena Sprinkler Outage Request

All,

Please see the attached sprinkler outage request for Neville Arena. Let me know if you have any questions.

Thanks,

Justin Gilliam

Construction Project Manager

Auburn University Facilities Management

1161 W Samford Ave, Auburn University, AL 36849

C: 334.734.3273 | jmg0047@auburn.edu



RE: Neville Arena Sprinkler Outage Request

From Bob Hix <hixjame@auburn.edu>

Date Mon 2025-05-19 9:11 AM

To Justin Gilliam <jmg0047@auburn.edu>; Eric Moore <jem0028@auburn.edu>; Bruce Arnold <gba0004@auburn.edu>; Scott McClure <mccluws@auburn.edu>; Fred Buchanan <buchaf1@auburn.edu>; Travis Tally <tallytp@auburn.edu>; Nolan Yon <yonbenj@auburn.edu>; Jessica Covington <jlc0105@auburn.edu>; Elizabeth De Kruif <erd0023@auburn.edu>

Cc Anna Thompson <gueriak@auburn.edu>

Approved

Bob Hix, P.E.

C: 334-740-8247 | bobhix@auburn.edu

From: Justin Gilliam <jmg0047@auburn.edu>

Sent: Monday, May 19, 2025 8:56 AM

To: Eric Moore <jem0028@auburn.edu>; Bruce Arnold <gba0004@auburn.edu>; Scott McClure <mccluws@auburn.edu>; Fred Buchanan <buchaf1@auburn.edu>; Travis Tally <tallytp@auburn.edu>; Bob Hix <hixjame@auburn.edu>; Nolan Yon <yonbenj@auburn.edu>; Jessica Covington <jlc0105@auburn.edu>; Elizabeth De Kruif <erd0023@auburn.edu>

Cc: Anna Thompson <gueriak@auburn.edu>

Subject: Neville Arena Sprinkler Outage Request

All,

Please see the attached sprinkler outage request for Neville Arena. Let me know if you have any questions.

Thanks,

Justin Gilliam

Construction Project Manager

Auburn University Facilities Management

1161 W Samford Ave, Auburn University, AL 36849

C: 334.734.3273 | jmg0047@auburn.edu



RE: Neville Arena Sprinkler Outage Request

From Travis Tally <tallytp@auburn.edu>

Date Mon 2025-05-19 9:21 AM

To Justin Gilliam <jmg0047@auburn.edu>; Eric Moore <jem0028@auburn.edu>; Bruce Arnold <gba0004@auburn.edu>; Scott McClure <mccluws@auburn.edu>; Fred Buchanan <buchaf1@auburn.edu>; Bob Hix <hixjame@auburn.edu>; Nolan Yon <yonbenj@auburn.edu>; Jessica Covington <jlc0105@auburn.edu>; Elizabeth De Kruif <erd0023@auburn.edu>

Cc Anna Thompson <gueriak@auburn.edu>

I approve.

From: Justin Gilliam <jmg0047@auburn.edu>

Sent: Monday, May 19, 2025 8:56 AM

To: Eric Moore <jem0028@auburn.edu>; Bruce Arnold <gba0004@auburn.edu>; Scott McClure <mccluws@auburn.edu>; Fred Buchanan <buchaf1@auburn.edu>; Travis Tally <tallytp@auburn.edu>; Bob Hix <hixjame@auburn.edu>; Nolan Yon <yonbenj@auburn.edu>; Jessica Covington <jlc0105@auburn.edu>; Elizabeth De Kruif <erd0023@auburn.edu>

Cc: Anna Thompson <gueriak@auburn.edu>

Subject: Neville Arena Sprinkler Outage Request

All,

Please see the attached sprinkler outage request for Neville Arena. Let me know if you have any questions.

Thanks,

Justin Gilliam

Construction Project Manager

Auburn University Facilities Management

1161 W Samford Ave, Auburn University, AL 36849

C: 334.734.3273 | jmg0047@auburn.edu



Re: Neville Arena Sprinkler Outage Request

From Elizabeth De Kruif <erd0023@auburn.edu>

Date Mon 2025-05-19 9:37 AM

To Travis Tally <tallytp@auburn.edu>; Justin Gilliam <jmg0047@auburn.edu>; Eric Moore <jem0028@auburn.edu>; Bruce Arnold <gba0004@auburn.edu>; Scott McClure <mccluws@auburn.edu>; Fred Buchanan <buchaf1@auburn.edu>; Bob Hix <hixjame@auburn.edu>; Nolan Yon <yonbenj@auburn.edu>; Jessica Covington <jlc0105@auburn.edu>

Cc Anna Thompson <gueriak@auburn.edu>

RMS approves.



From: Travis Tally <tallytp@auburn.edu>

Date: Monday, May 19, 2025 at 9:21 AM

To: Justin Gilliam <jmg0047@auburn.edu>, Eric Moore <jem0028@auburn.edu>, Bruce Arnold <gba0004@auburn.edu>, Scott McClure <mccluws@auburn.edu>, Fred Buchanan <buchaf1@auburn.edu>, Bob Hix <hixjame@auburn.edu>, Nolan Yon <yonbenj@auburn.edu>, Jessica Covington <jlc0105@auburn.edu>, Elizabeth De Kruif <erd0023@auburn.edu>

Cc: Anna Thompson <gueriak@auburn.edu>

Subject: RE: Neville Arena Sprinkler Outage Request

I approve.

From: Justin Gilliam <jmg0047@auburn.edu>

Sent: Monday, May 19, 2025 8:56 AM

To: Eric Moore <jem0028@auburn.edu>; Bruce Arnold <gba0004@auburn.edu>; Scott McClure <mccluws@auburn.edu>; Fred Buchanan <buchaf1@auburn.edu>; Travis Tally <tallytp@auburn.edu>; Bob Hix <hixjame@auburn.edu>; Nolan Yon <yonbenj@auburn.edu>; Jessica Covington <jlc0105@auburn.edu>; Elizabeth De Kruif <erd0023@auburn.edu>

Cc: Anna Thompson <gueriak@auburn.edu>

Subject: Neville Arena Sprinkler Outage Request

All,