






Facilities Management
1161 West Samford Avenue
Tuscaloosa, AL 35689
Phone: (334) 844-9450
Fax: (334) 844-9458
Safety: (334) 844-9459
Think Safety. Act Safe.


No.	Revised	Date
1	ISSUED	08/01/21
2	CONSTRUCTION	08/01/21
3	AS-BUILT	08/01/21

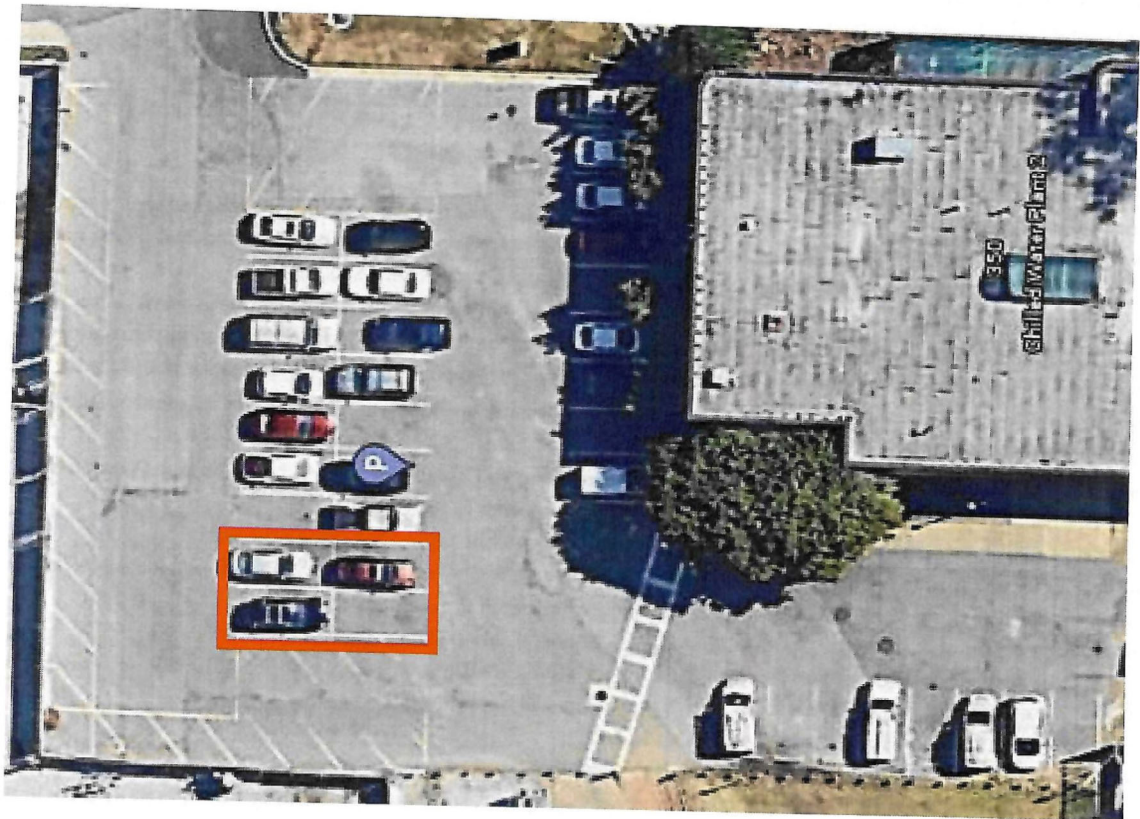

HEISMAN DRIVE
Tree and Landscape Improvements
For Campus Green Transit
Hub Area
Project Number 20-384

SHEET TITLE:
PLANTING PLAN
HEISMAN PARK
TRAIL
(ADD ALTERNATE #1)
DRAWN BY:
CHECKED BY:
DATE: 08/01/21
BUILDING NUMBER:
N/A
SHEET NAME:
PROJECT NUMBER:
20-384
SHEET NUMBER:

L3.1

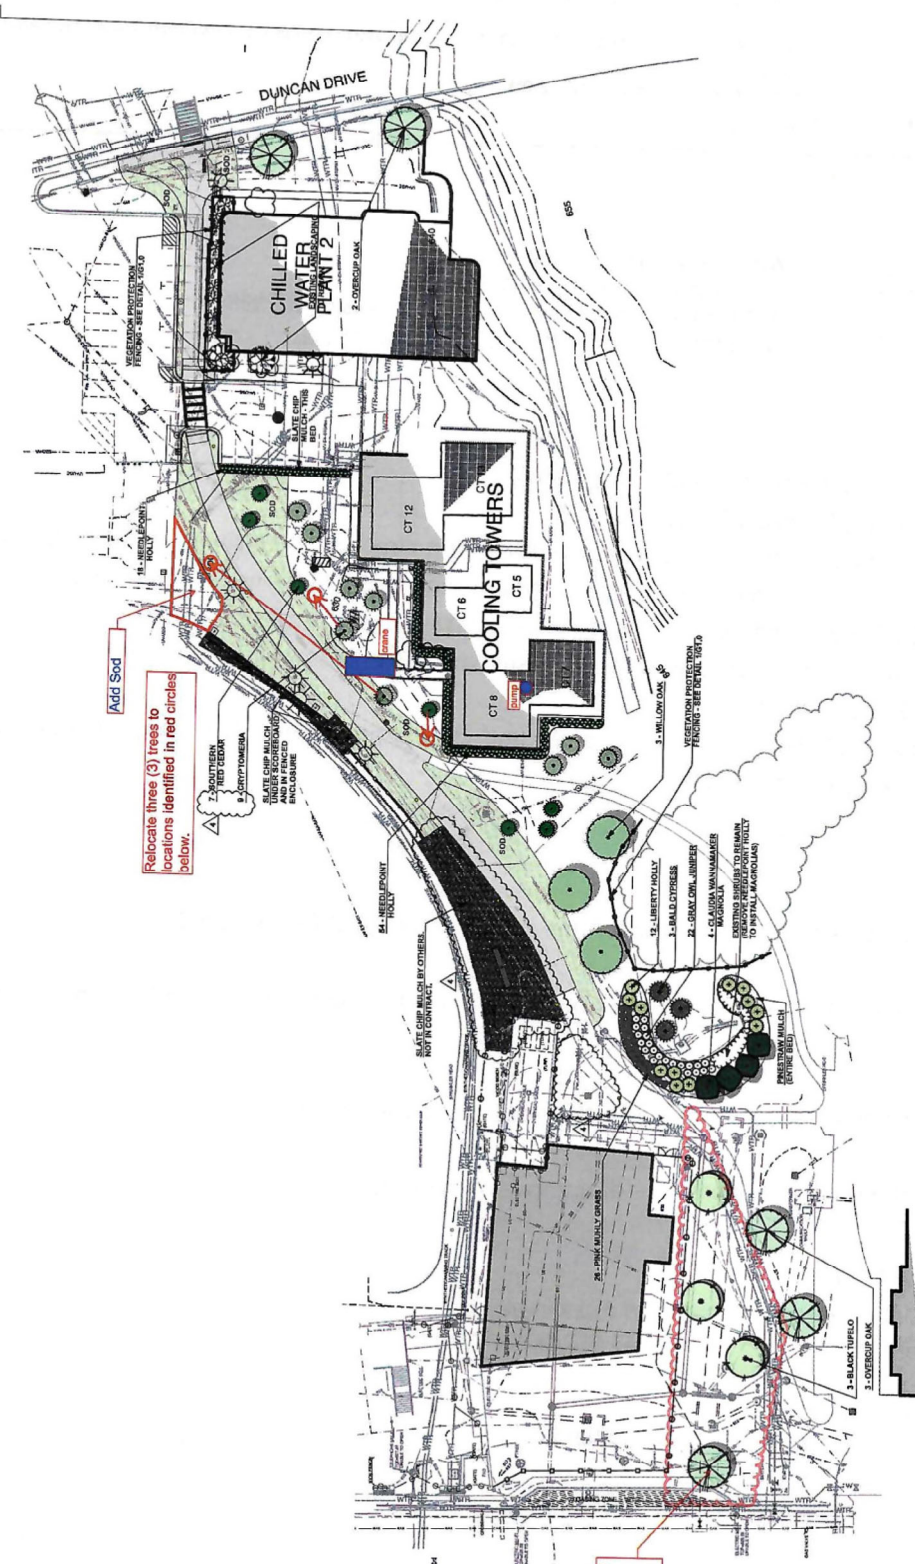

Add Sod

Relocate three (3) trees to locations identified in red circles below.

REMOVE THE OVERCUP AND THREE (3) BLACK TUPELOS. LANDSCAPE SERVICES WILL PLANT AT LATER DATE.