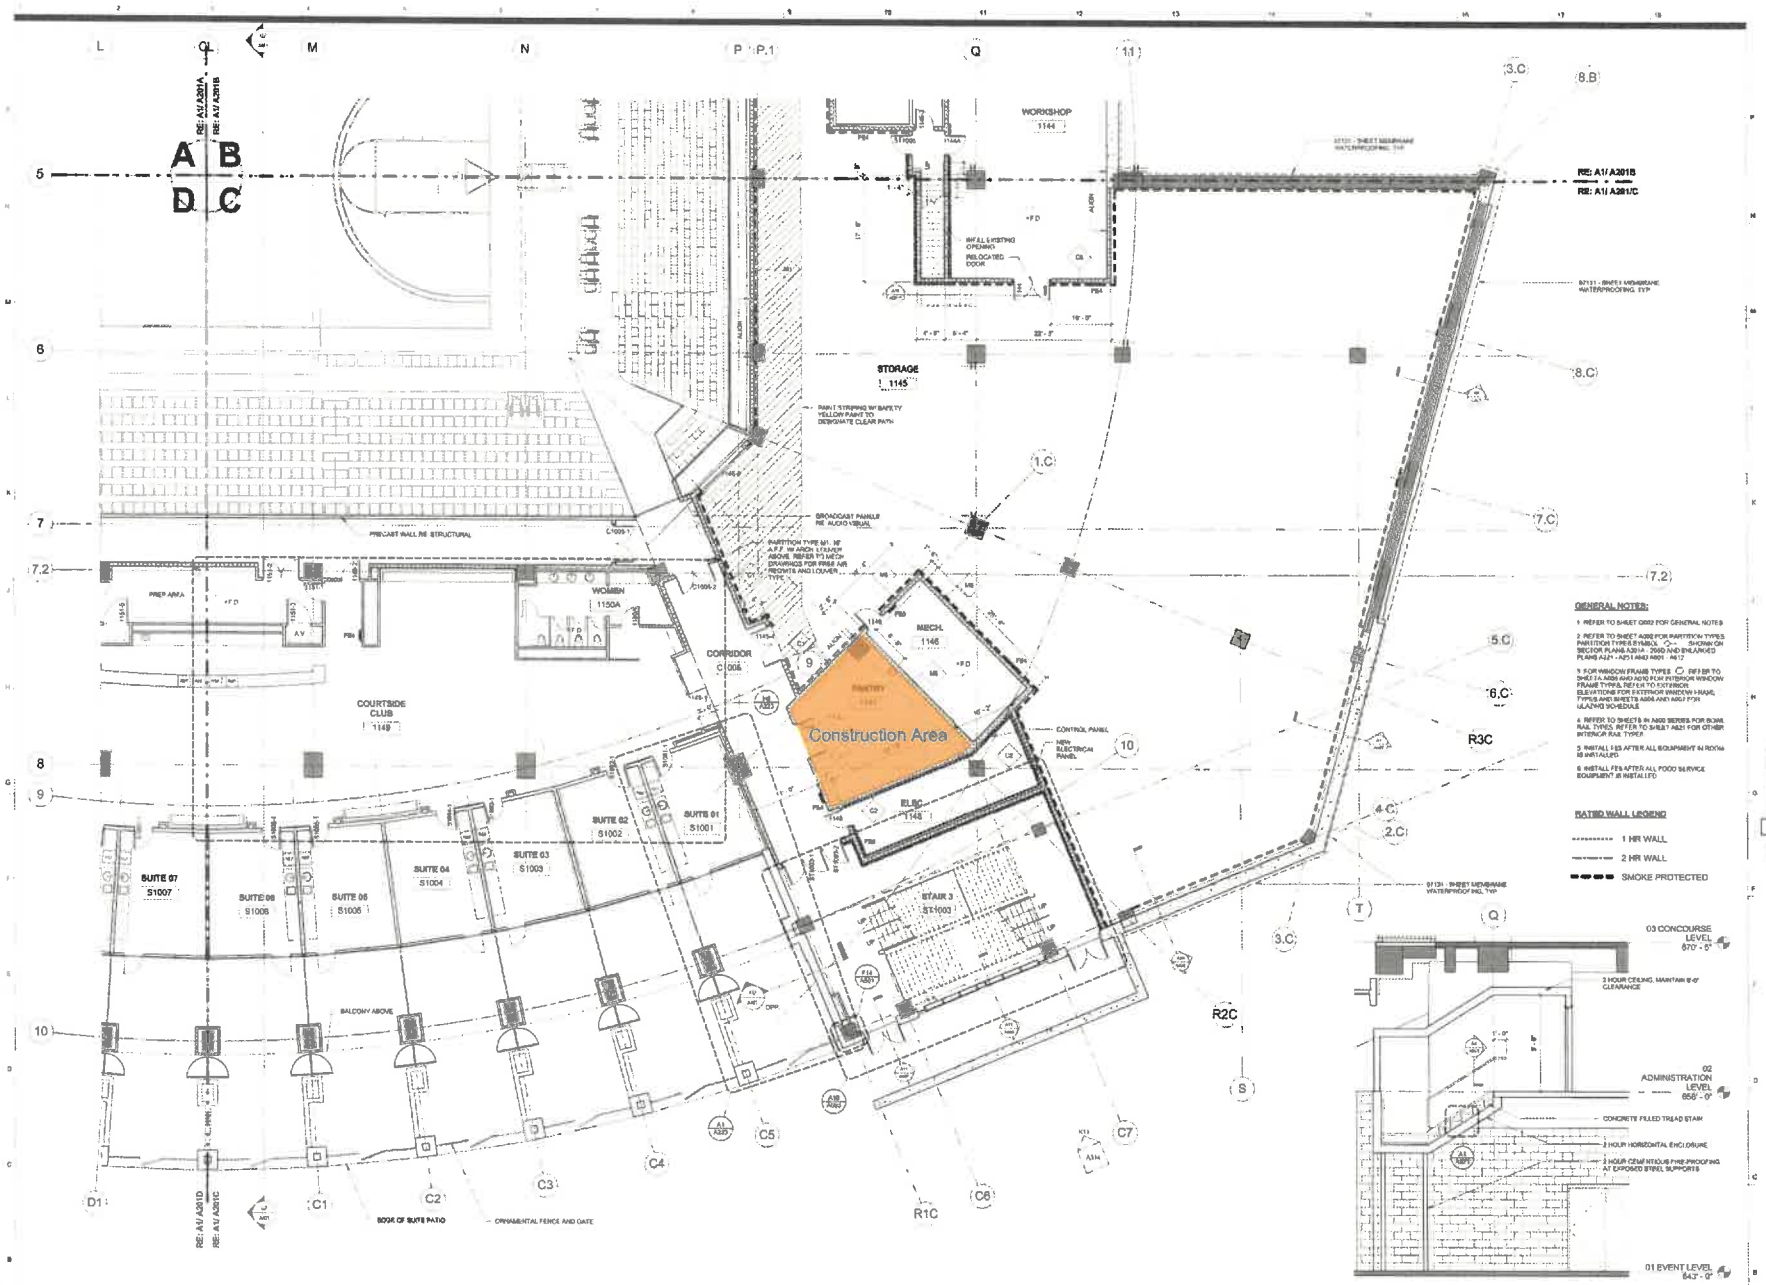

GENERAL NOTES:

1. REFER TO SHEET A002 FOR GENERAL NOTES
2. REFER TO SHEET A002 FOR PARTITION TYPES. PARTITION TYPES SYMBOL -SHOWN ON SECTOR PLANS A201 - 2000 AND ENLARGED PLANS A221 - A251 AND A601 - A612
3. FOR WINDOW FRAME TYPES REFER TO SHEET A. A005 AND A010 FOR EXTERIOR WINDOW FRAME TYPES, REFER TO EXTERIOR ELEVATIONS FOR EXTERIOR WINDOW FRAME TYPES AND SHEETS A005 AND A010 FOR GLAZING SCHEDULE
4. REFER TO SHEETS IN A000 SERIES FOR BUMP RAIL TYPES, REFER TO SHEET A621 FOR OTHER INTERIOR RAIL TYPES
5. INSTALL FES AFTER ALL EQUIPMENT IN ROOM IS INSTALLED
6. INSTALL FES AFTER ALL FOOD SERVICE EQUIPMENT IS INSTALLED

RATED WALL LEGEND

- 1 HR WALL
- 2 HR WALL
- SMOKE PROTECTED

A1 EVENT LEVEL SECTOR C
1/8" = 1'-0"

A15 SECTION AT STAIR
1/4" = 1'-0"

Auburn University Basketball Arena

Roosevelt Dr. & S. Donahue
Auburn, AL 36849

360° PROPERTY ARCHITECTURE

owner:
Auburn University
Office of President-Facilities Div
Samford Hall
Auburn, AL 36849

construction management:
Robins & Morton
465 Shades Creek Parkway
Birmingham, AL 35209
T: 205.870.1000

architect:
360 Architecture Inc
300 West 23rd Street
KANSAS CITY, MO 64108
T: 816.472.3969
F: 816.472.2969

associate architect:
Dyda Architects, Inc.
120 23rd St., South
Birmingham, AL 35233
T: 205.322.2487

structural:
Walter P. Moore & Associates
535 Main Street, 10th Floor
Kansas City, MO 64105-2005
T: 816.791.2100

associate structural:
SBSA Structural Engineers
300 20th Street North, Suite 200
Birmingham, AL 35203
T: 205.323.5300

mechanical, electrical, plumbing & fire protection
Smith Seckman Reid, Inc.
5200 Baker Drive
Nashville, TN 37204
T: 615.383.1113

civil:
LBYD, Inc.
716 South 19th Street
Birmingham, AL 35233
T: 205.324.4000

landscape architect:
Holcombe Harrison & Pritchett
1914 20th Avenue South
Birmingham, AL 35205
T: 205.918.9000

audio/visual audio-visual consultant:
SHANK, Inc
4801 Spring Valley Road #113
Dallas, TX 75244
T: 972 934 3500

data consultant:
PBC, Inc.
3100 South 24th Street, Suite E
Kansas City, KS 66106
T: 913.722.3472

food service consultant:
The Spectator Company, Inc.
1375 Universal Avenue, Suite 100
Kansas City, MO 64120
T: 816.483.5882
F: 816.483.5816

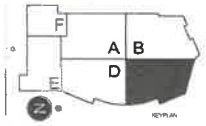

COPYRIGHT © 2009 360 ARCHITECT, INC. INC.

signature

No	Date	Description
1	03/13/09	Construction Set ASI-124
2	06/01/09	ASI 141
	09/15/10	Record Set

Issue Date March 13, 2009
100% Construction Documents
Bidding / Permit
360 Architecture Project 070260 00

Event Level Sector C

sheet number
A201C

8/19/2010 10:09:57 AM